


AS-BUILT FLOOR PLAN

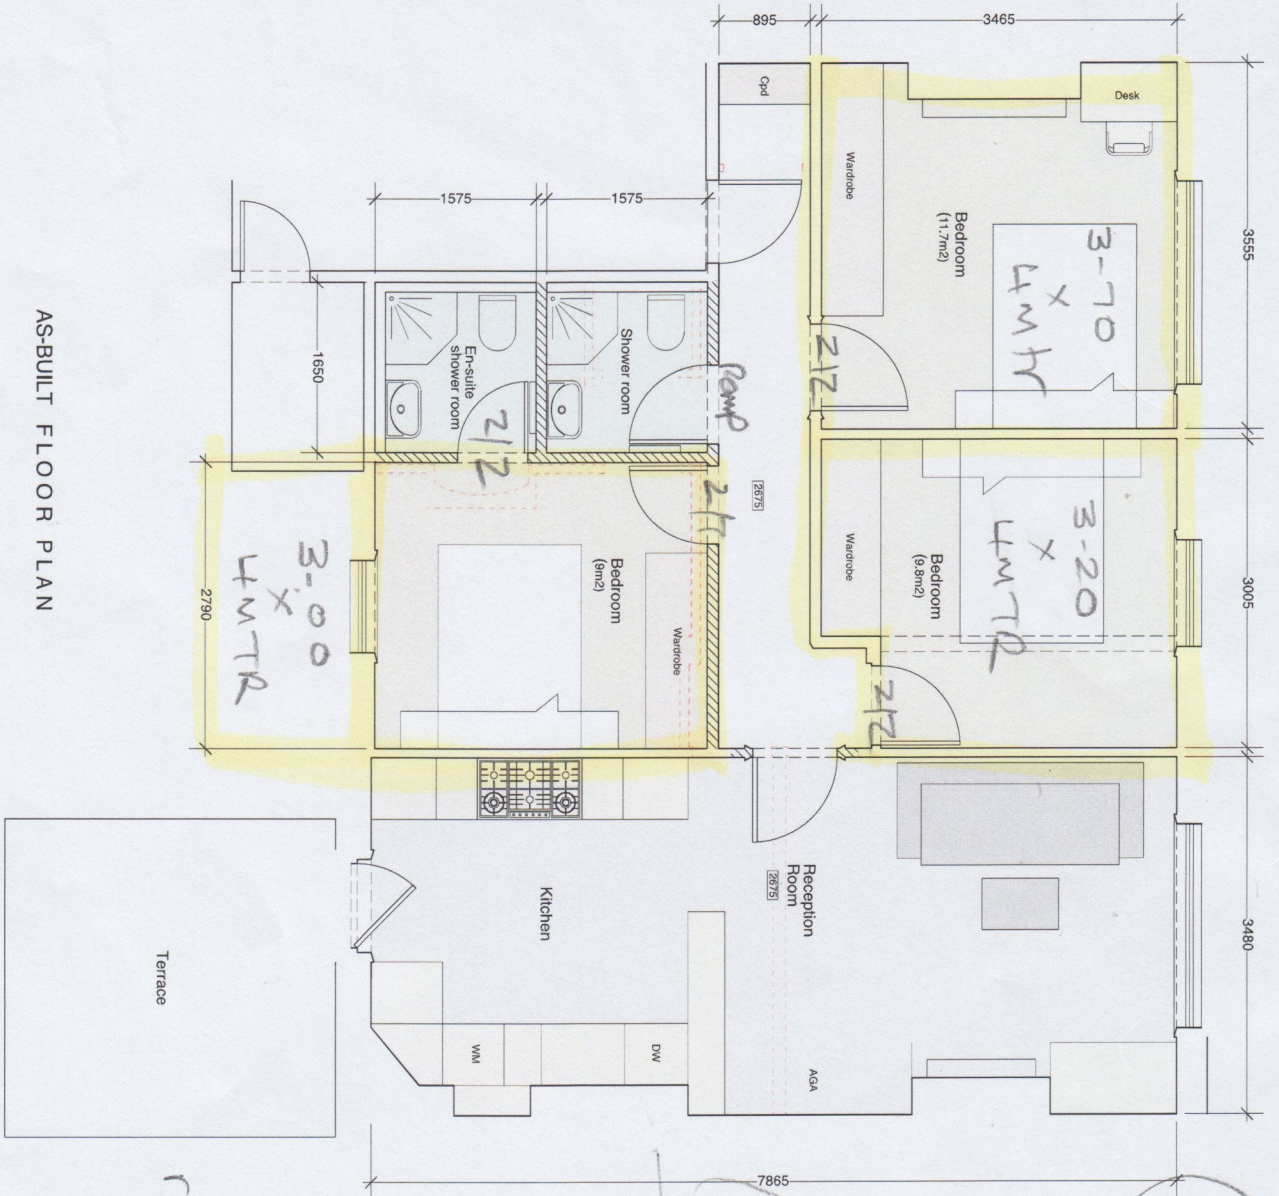

(Rob Bradley)



F29678

08 RESIDENTIAL  
FLAT 1  
15 PICTON PLACE  
LONDON  
W1U 1BW

3-70 x 4m x 4m  
3-20 x 4m x 4m  
3-00 x 4m x 4m  
10-00 x 4m x 4m  
(40)

OB Residential

M-07736-126696  
W-020-33263987

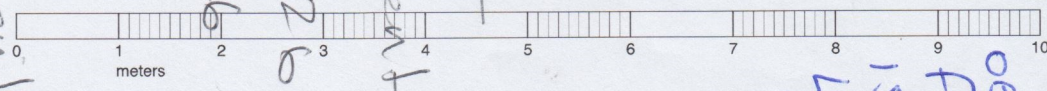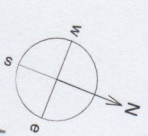

road residential by

Chris Scott Architects

235 Ulverscroft Road  
London  
SE22 9HG  
07880 528716

Job: Job 15 Picton Place, W1U 1BW

Dwg: D21 - As-built Floor Plan

Scale: 1:50 @ A3

Date: August 2023