

* Phase 1 = All Areas MARKED in yellow & orange

P26956
Clare Gaskin Int.
The Warren


1 of 10

Westend (Standard)
Colour ONYX.

- Cut Plan ① 1145 x 500
 - Cut Plan ② 1285 x 500
 - Cut Plan ③ 390 x 500
 - Cut Plan ④ 1035 x 500
- 38.55 x 500
= 192.75 m²


Roll A	Roll B
2500 x 500	1450 x 500
1145	390
1285	1035
2430	1425

* MARK up remainder of Cutting Plans & store in WH until Phase 2

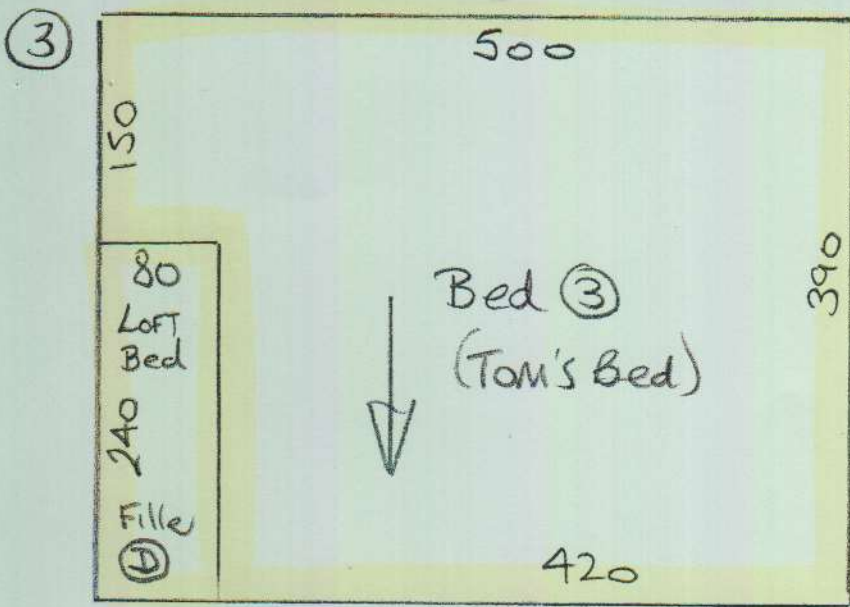


P26956
Clare Gaskin Int
The Warren

2 of 10

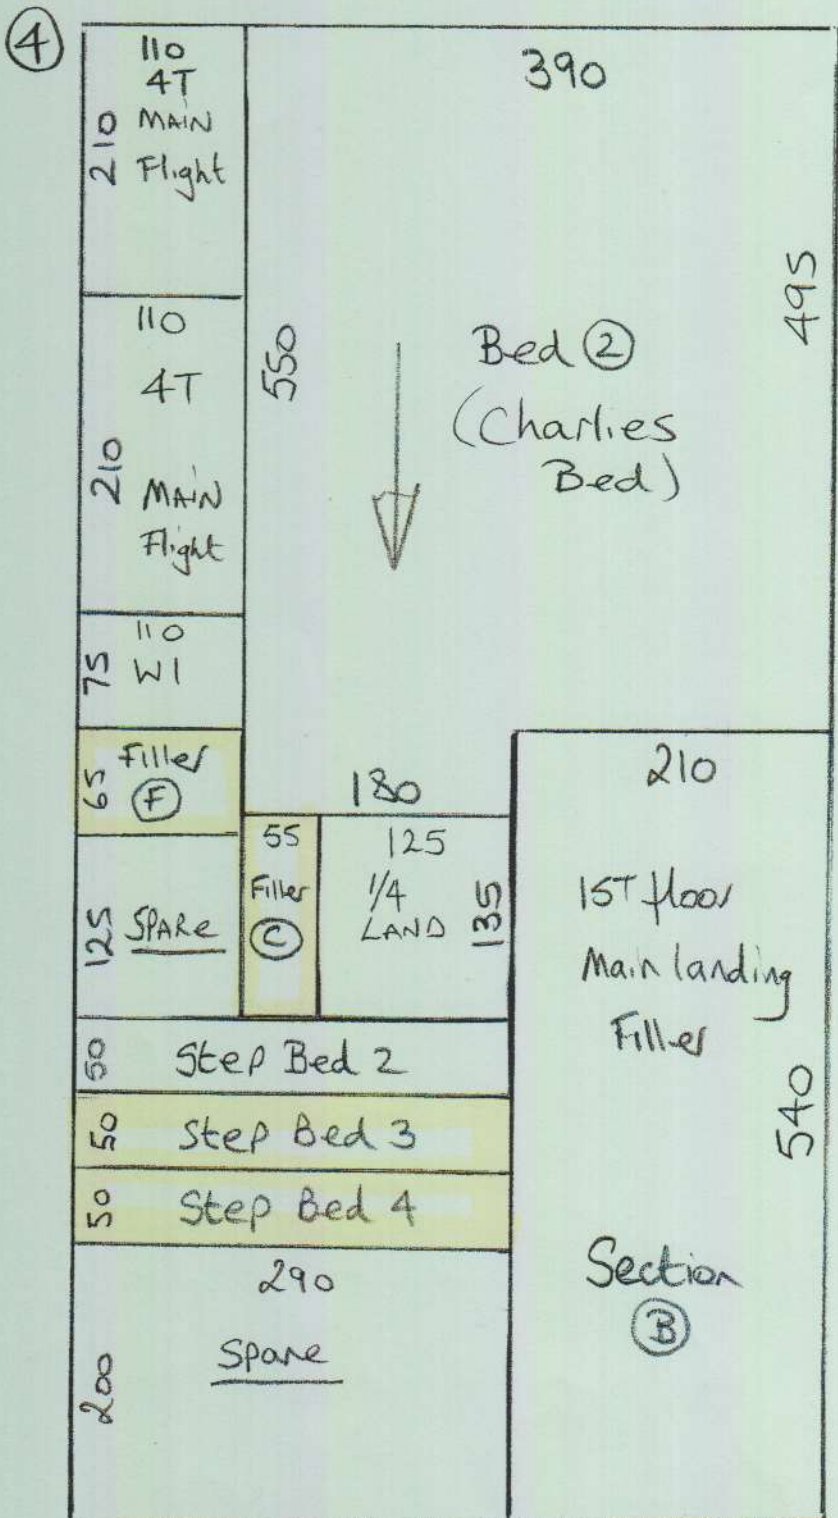

Westend Standard
Col. onyx




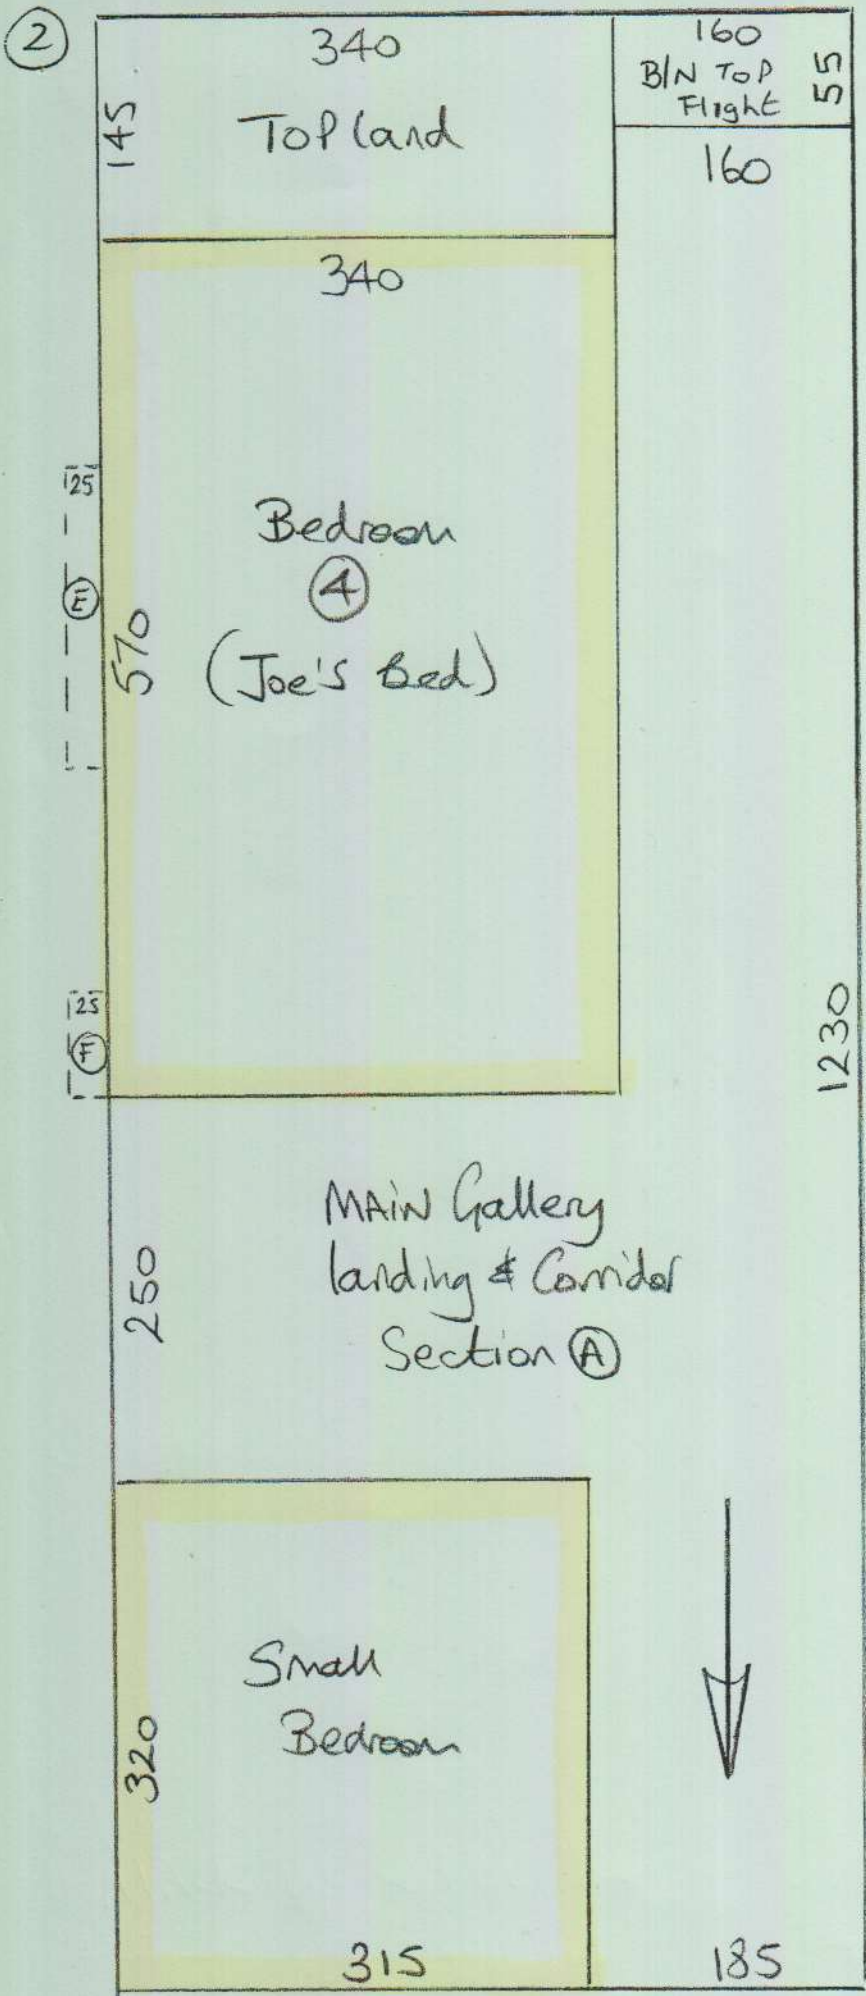

P26956
Clare Gaskin Int
The Warren

3 of 10

Westend Standard
Col. Onyx

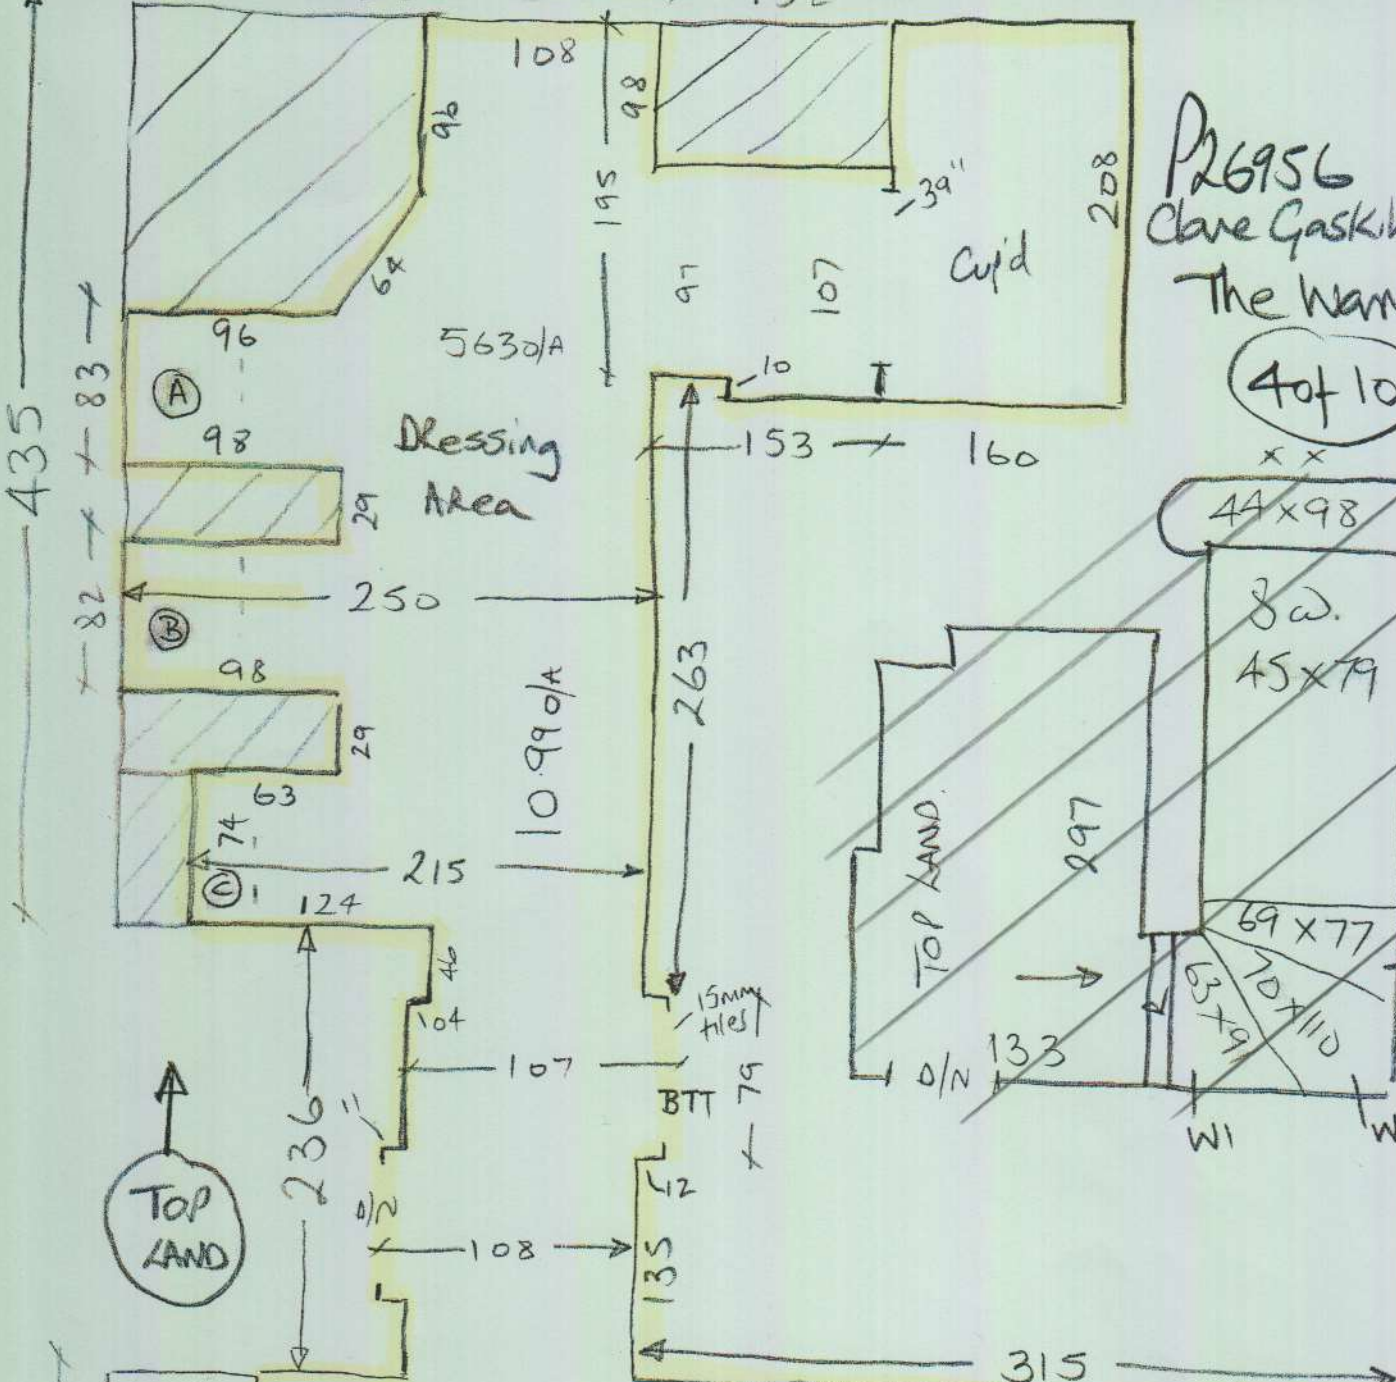


P26956
Clare Gaskin Int

4 of 10

TOP LAND

TOP LAND

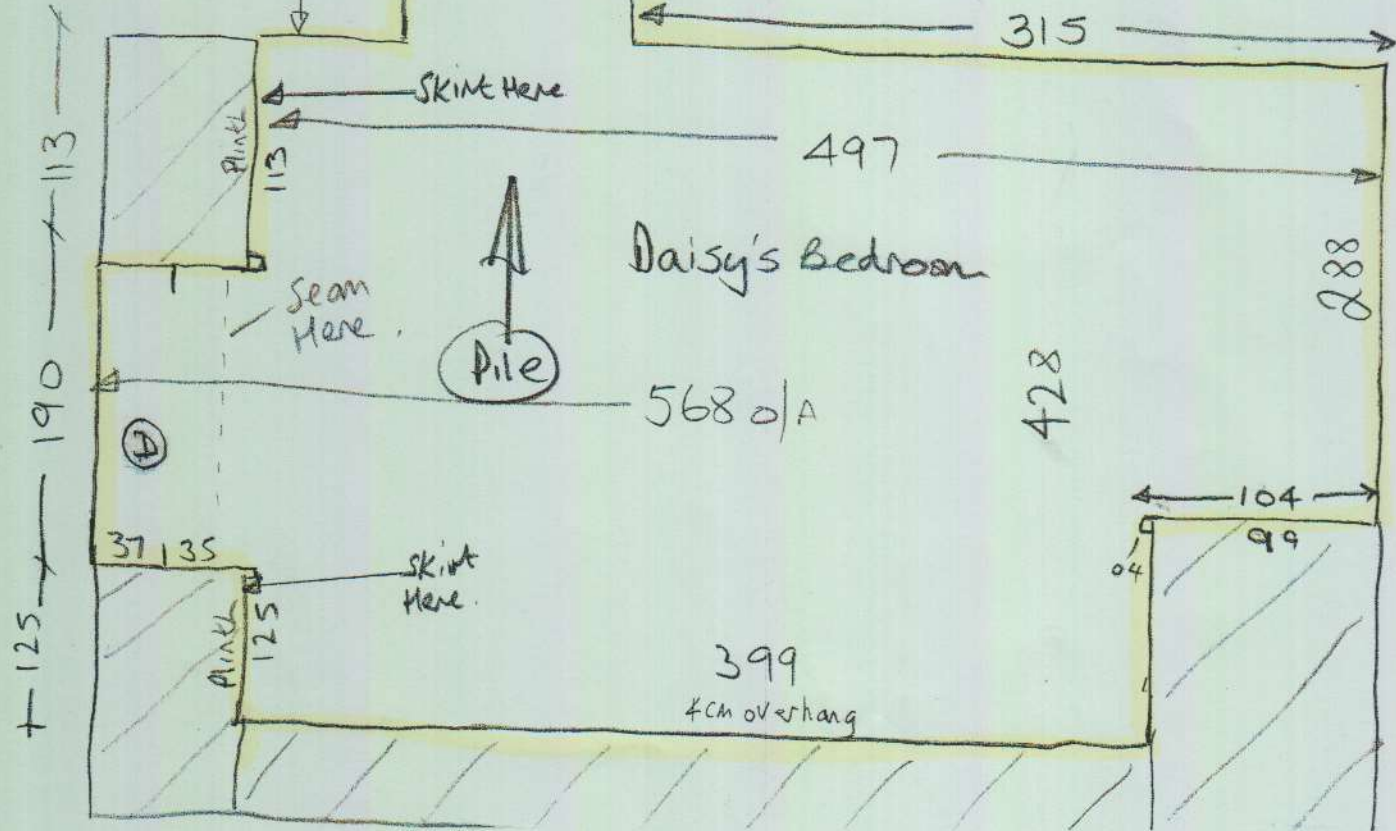

Daisy's Bedroom

Pile


Seam Here

Skirt Here

Skirt Here

Skirt Here

399
4cm overhang

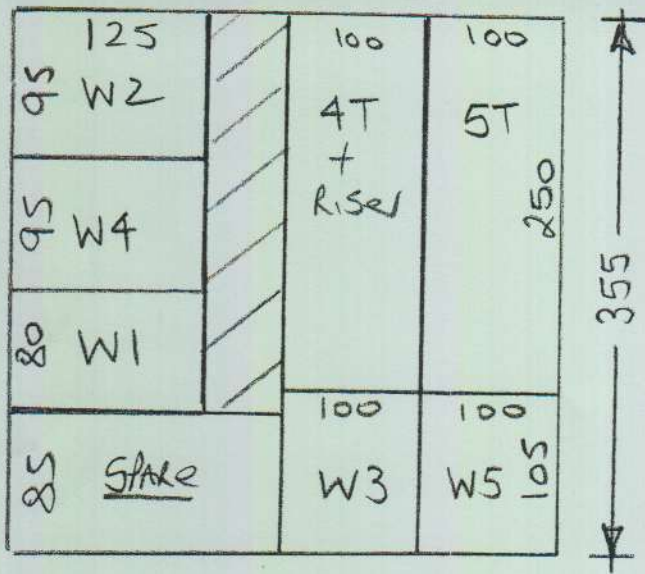

P26956
Clare Gaslin Int
The Warren

7 of 10

Westend Prestige
Colour Ruby

Cinema Room (A) 685 x 366

Cinema Room (B) 685 x 366

Cut Plan 355 x 366

$$\begin{aligned} &\rightarrow 1725 \times 366 \\ &= \underline{\underline{63.13\text{m}^2}} \end{aligned}$$

ORDERED 17.50 x 366

* Large table tennis / Pool table to move
+ Lots of stuff in under stairs Cup'd



Cut back unnatural flooring around edge of
unnatural flooring & stick sledge

Basement Cinema Room + STAIRS

P26956
Clare Gaskin Ltd
The Warren

Westend Prestige - Colour Ruby


8 of 10

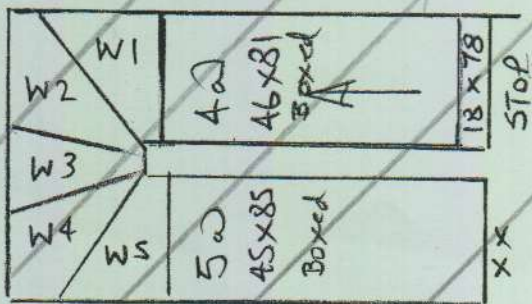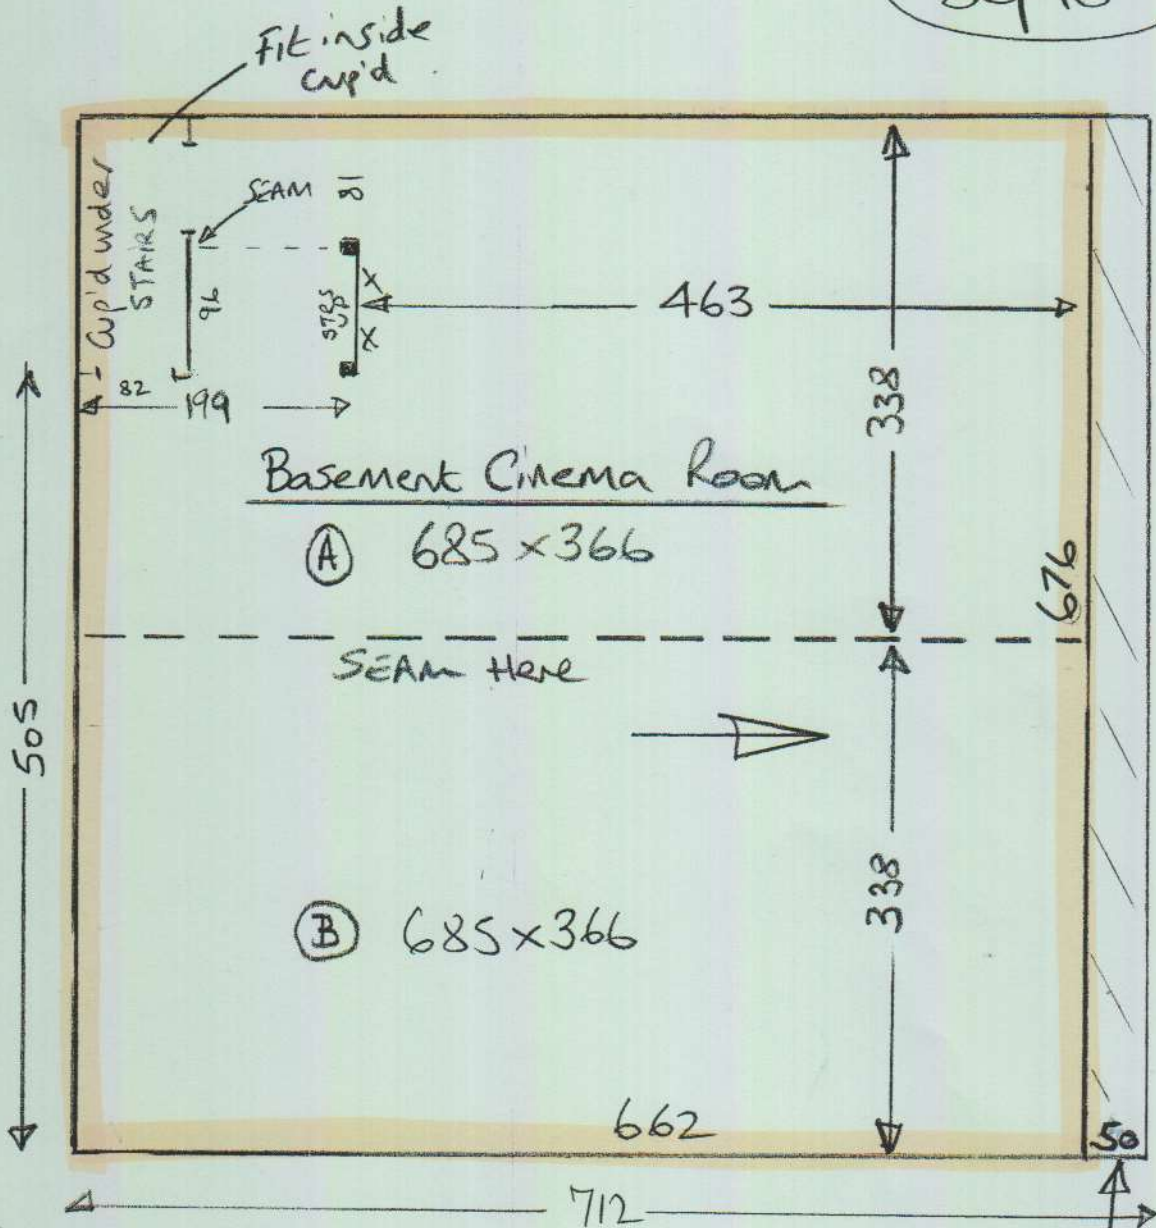

- W1 70x100
- W2 83x112
- W3 73x84
- W4 75x115
- W5 84x83

*TV/AV unit
Built in
4cm overhang
on front



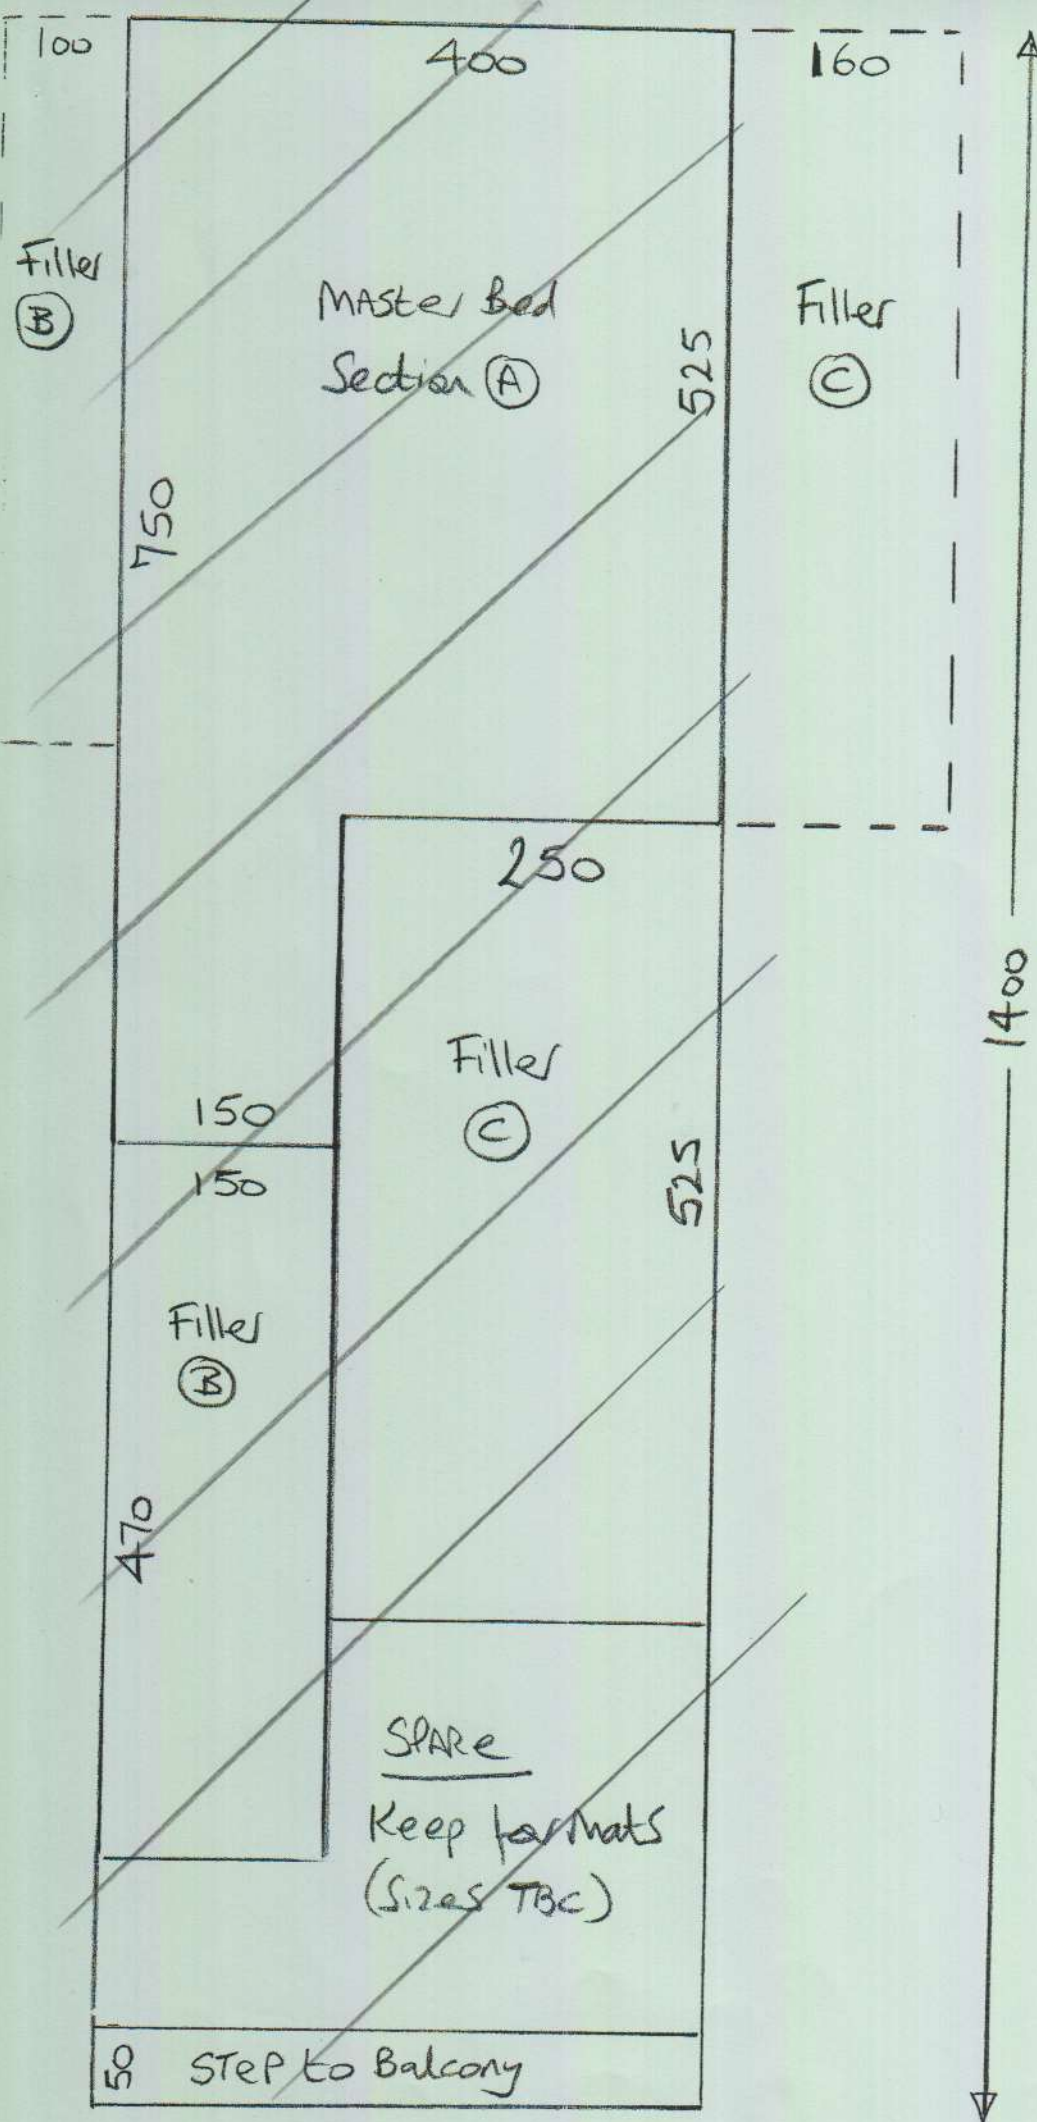

P26956
 Clare Gaskin Int
 The Warren



9 of 10

FAUX SILK.

Col. FAU 017

Cut Plan 1400x400
 = 56m²

second floor plan

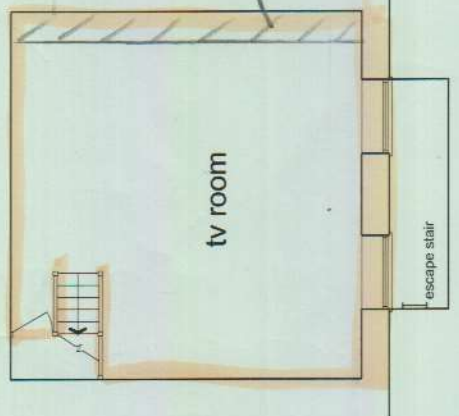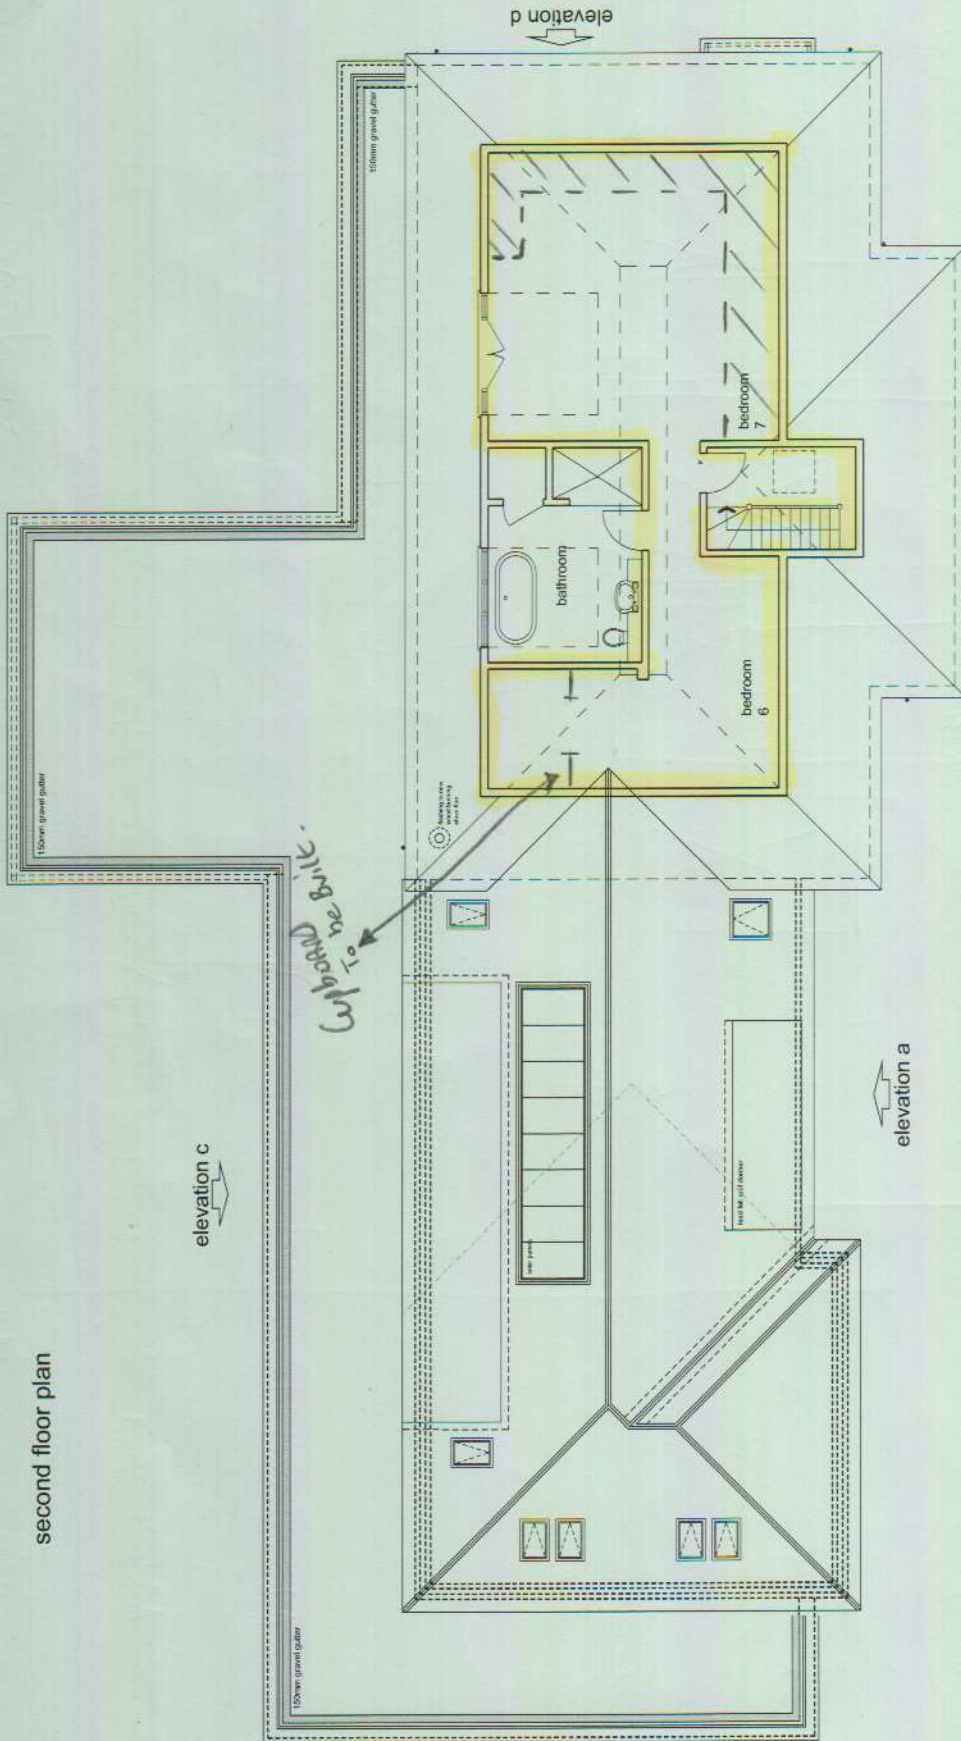

basement plan

notes:
 any discrepancies should be reported immediately.
 all dimensions should be checked on site prior to commencement of work.

© HERTFORD PLANNING SERVICE
 notes:

Hertford Planning Service Westgate House, 37-41 Castle Street, Hertford, Herts SG14 1HH Tel: 01992 553173 Fax: 01992 587643 Email: info@hertfordplanning.co.uk www.hertfordplanning.co.uk	
	Client: Mr S & Mrs J Dalton
Project: The Warren Hertfordshire SG14 2LF	Drawing: Attic and Basement Layouts
Date: 16/02/16 Scale: 1:50 Drawn: mfb	11623-D304


notes:
 any discrepancies should be reported immediately
 all dimensions should be checked on site prior to commencement of work
 site survey based on evidence as given

© HERTFORD PLANNING SERVICE
 note:
 this is a preliminary design only. It is the responsibility of the user to verify that the resulting plans are to scale on the appropriate sized sheet.
 the scale bars shown on the plan measure correctly.

Hertford Planning Service
 Westgate House, 37-41 Castle Street,
 Hertford, Herts SG14 1HH
 Tel: 01992 553173 Fax: 01992 587643
 Email: hps@hertfordplanning.co.uk
 www.hertfordplanning.co.uk

Client: Mr S & Mrs J Bolton
 Project: The Warren
 Hattingsleybury
 SG14 2LF
 Drawing: Ground Floor Layout

Date: 18/02/2016
 Scale: 1:50
 Drawn: A. mfo
 11623-D302

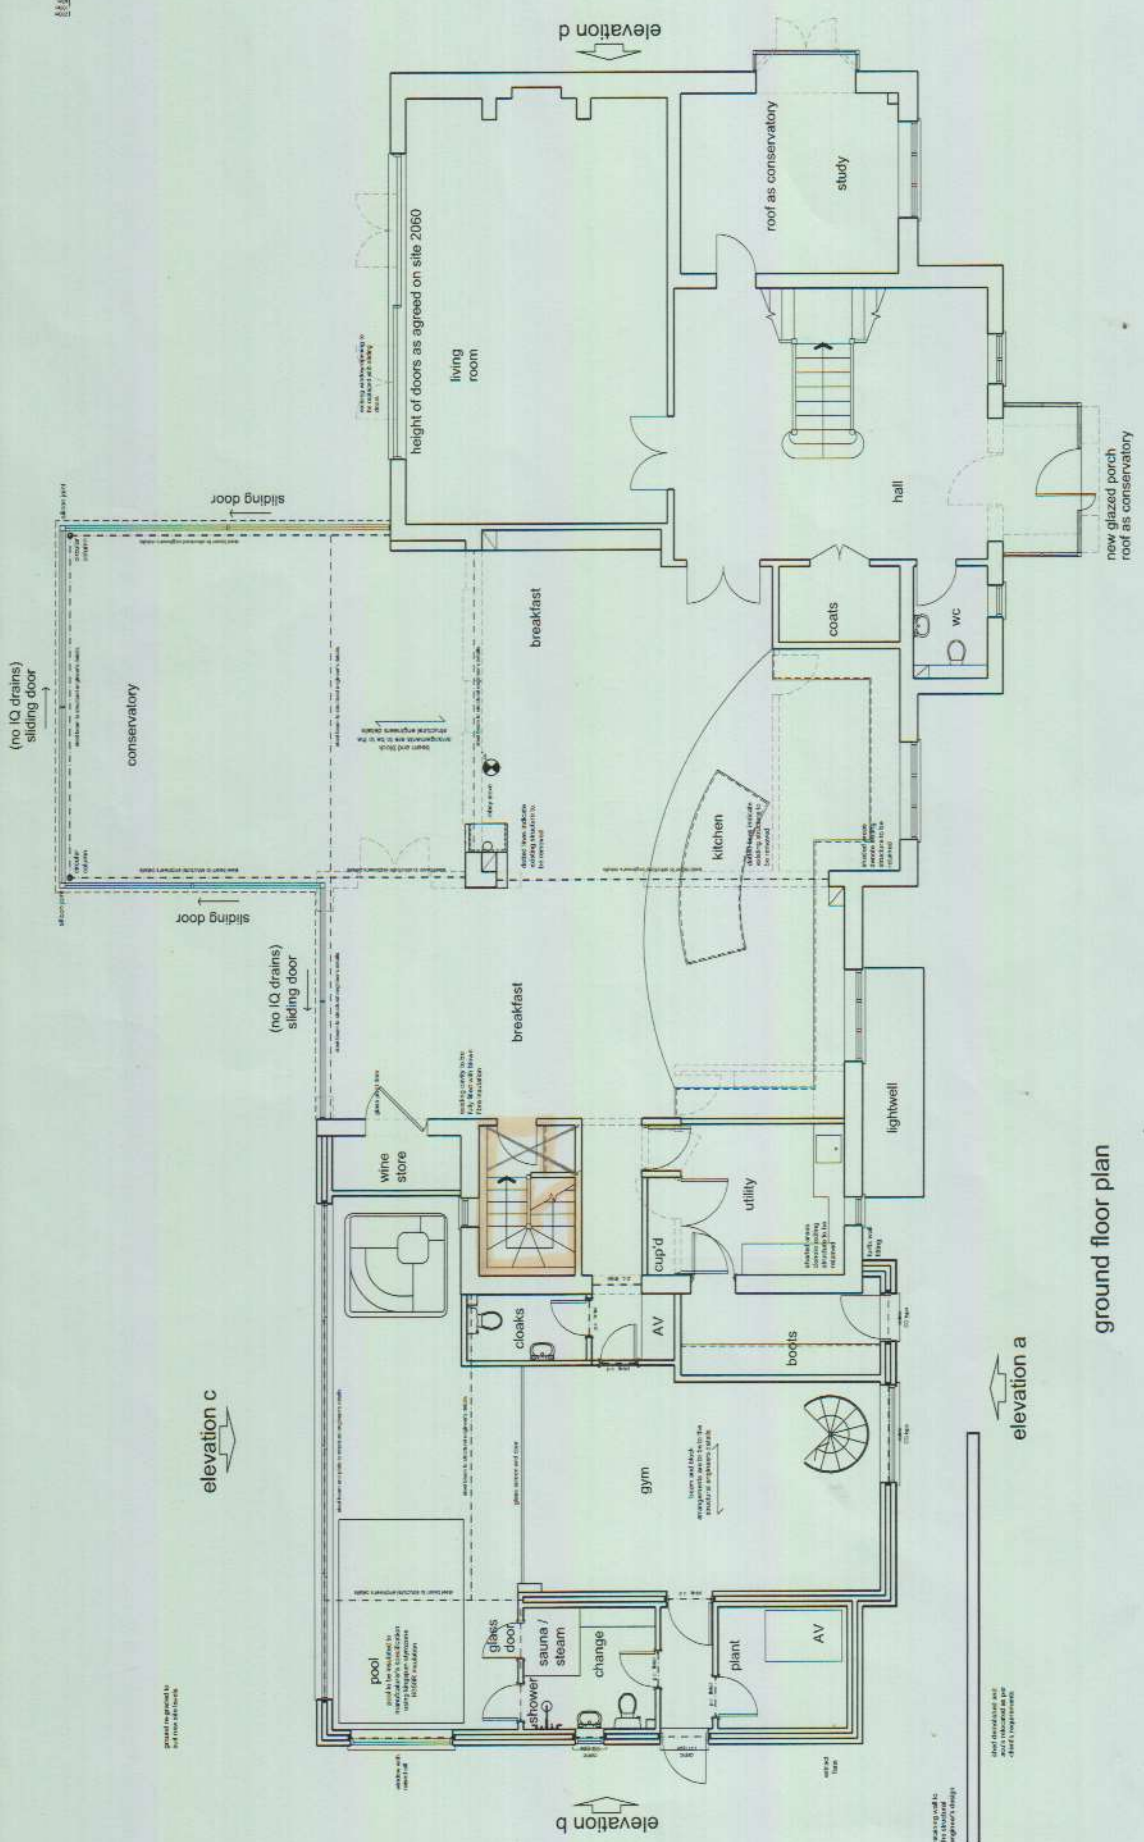

ground floor plan

any discrepancies should be reported immediately
 all dimensions should be checked on site prior to commencement of work
 site survey based on evidence as given
